#### PHASE CHART R Y G R Y G R Y G R Y G R PHASE 2 + 6G 2 + 6 CHANGE PHASE 4 4 CHANGE FLASHING FL/Y FL/Y FL/R FL/R FL/Y FL/Y OPERATION

### PROJECT DESCRIPTION

GENERAL
THIS PORTION OF THE PROJECT INVOLVES THE MODIFICATION OF THE EXISTING TRAFFIC
CONTROL SIGNAL AT MD 7 AND INDUSTRIAL PARK ROAD IN BALTIMORE COUNTY. MD 7 IS
ASSUMED TO RUN IN A EAST-WEST DIRECTION.

#### INTERSECTION OPERATION

THE SIGNAL WILL OPERATE IN A NEMA THREE-PHASE, FULL-TRAFFIC-ACTUATED MODE, WITH MD 7 APPROACHES RUNNING CONCURRENTLY AND INDUSTRIAL PARK ROAD RUNNING ALONE.

# PROJECT CONTACTS

THE CONTACT PERSONS FOR DISTRICT #4 ARE AS FOLLOWS:

MR. RANDALL SCOTT
ASSISTANT DISTRICT
ENGINEER - TRAFFIC
PHONE: (410) 321-2781

MR. JOE McMAHON UTILITY ENGINEER PHONE: (410) 321-2780 MR. RICHARD L. DAFF, SR. CHIEF, TRAFFIC OPERATIONS DIVISION PHONE: (410) 787-7630

THE POWER COMPANY REPRESENTATIVE IS:

BALTIMORE GAS ELECTRIC COMPANY
MR. JOSEPH G. BUNCH
INDUSTRIAL / COMMERCIAL SERVICES
NEW BUSINESS CONSTRUCTION
7317 PARKWAY DRIVE SOUTH
PHONE: (410) 859-9030


MR. PHILIP HUMBERTSON SPECIAL PROJECTS PHONE: (410) 321-2851


# EQUIPMENT LIST "B"

B. EQUIPMENT TO BE SUPPLIED AND/OR INSTALLED BY THE CONTRACTOR:

SPEC. SECTION.	CATEGORY CODE NO.	QUANTITY	DESCRIPTION
104	120500	L.S.	MAINTENANCE OF TRAFFIC
104	114245	25 L.F.	FURNISH AND INSTALL REMOVABLE PREFORMED PAVEMENT MARKING TAPE (STOP LINE)
104	114250	1 EACH	FURNISH AND INSTALL REMOVABLE PREFORMED PAVEMENT MARKING ARROW
205	203030	1 C.Y.	TEST PIT EXCAVATION
801	801004	4.65 C.Y.	FURNISH AND INSTALL CONCRETE FOR SIGNAL FOUNDATION
805	870160	350 L.F.	FURNISH AND INSTALL 2 IN. SCHEDULE 80 RIGID PVC CONDUIT - TRENCHED
805	805150	150 L.F.	FURNISH AND INSTALL 3 IN. SCHEDULE 80 RIGID PVC CONDUIT - BORED
806	831010	1 EACH	FURNISH AND INSTALL 250 WATT H.P.S. LAMP AND LUMINAIRE WITH PHOTOCELL
810	861116	300 L.F.	FURNISH AND INSTALL ELECTRICAL CABLE - 2-CONDUCTOR (NO 12 AWG)
810	861107	25 L.F.	FURNISH AND INSTALL ELECTRICAL CABLE - 5-CONDUCTOR (NO. 14 AWG)
810	861108	340 L.F.	FURNISH AND INSTALL ELECTRICAL CABLE - 7-CONDUCTOR (NO. 14 AWG)
810	802501	30 L.F.	FURNISH AND INSTALL NO.6 STRANDED BARE COPPER GROUND WIRE
814	860265	4 EACH	RELOCATE EXISTING SIGNAL HEAD
814	800000	4 EACH	RELOCATE EXISTING SIGN ON MAST ARM
	800000	L.S.	REMOVE AND DISPOSE OF EXISTING MATERIAL AND EQUIPMENT
814	860272	6 EACH	FURNISH AND INSTALL 12 INCH BLACK FACE VEHICULAR TRAFFIC SIGNAL HEAD SECTION
818	866104	1 EACH	FURNISH AND INSTALL 20 FT LIGHTING ARM ON SIGNAL STRUCTURE
818	818052	1 EACH	FURNISH AND INSTALL 27' STEEL POLE AND 70 FT MAST ARM
	800000	1 EACH	FURNISH AND INSTALL 3" WEATHER HEAD
	869102	170 L.F.	FURNISH AND INSTALL3/8" SPAN WIRE
	800000	1 EACH	REMOVE CLASS 2 WOOD POLE AND BACK GUYS
	800000	3 EACH	RE-AIM VIDEO DETECTION CAMERA
805	870163	25 L.F.	FURNISH AND INSTALL 3 IN. SCHEDULE 80 RIGID PVC CONDUIT — TRENCHED

### WIRING DIAGRAM

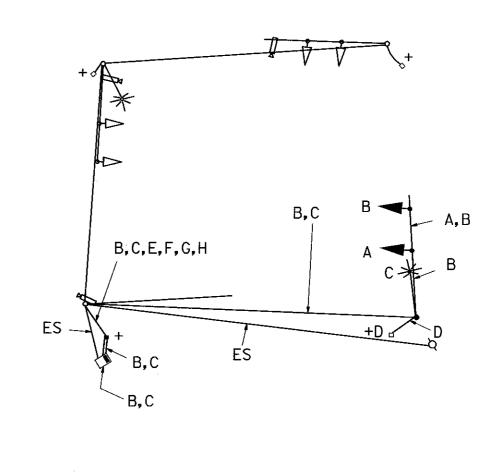

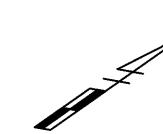

## WIRING KEY

- 5-CONDUCTOR ELECTRICAL CABLE (NO. 14 A.W.G.)
   7-CONDUCTOR ELECTRICAL
- ES EXISTING OVERHEAD
  ELECTRICAL SERVICE

   EXISTING 3/4 IN. × 10 FT.
  GROUND ROD
- CABLE (NO. 14 A.W.G.)

   2-CONDUCTOR ELECTRICAL
  CABLE TYPE T/C (NO. 12 A.W.G.)
- } STRANDED BARE COPPER GROUND WIRE (NO. 6 A.W.G.)

PHASE 2A TEMPORARY TRAFFIC SIGNAL

SS-IO

**REVISIONS** MARYLAND DOT - STATE HIGHWAY ADMINISTRATION Office of Traffic & Safety GEOMETRIC LEGEND TRAFFIC ENGINEERING DESIGN DIVISION (Traffic Signal Plan) EXISTING GEOMETRICS PROPOSED GEOMETRICS MD 7 (Philadelphia Road ) at RED LINE REVISION 6 MARCH 2002 THIS SHEET REPLACES SHEET 206 UTILITY LEGEND Industrial Park Road ---- • ---- GAS MAIN ----- WATER MAIN S.H.A. No. BA2135176 DLA DRAWN BY: A.A. SEWER MAIN F.A.P. NO. TS NO. E ELECTRIC CABLES HURST-ROSCHE ENGINEERS, INC.
50 Scott Adam Road
Suite 103
Cockeysville, MD 21030
410-683-1683 NOVEMBER, 2000 3<u>561A-X1B-G</u>I1 BW813-802-412 ---- STORM DRAIN CHECKED BY: J. A. B. S.H.A. NO. SHEET NO. MODIFY SIGNAL FOR NEW GEOMETRICS A ----- A ----- AERIAL CABLES BALTIMORE S.H.A. No. BA2135176 SCALE: <u>I' = 20'</u> COUNTY: T.I.M.S. NO. TELEPHONE CABLES D770 206A OF 237 9-26-95 LOG MILE: 03000706.62 DATE: